


RECORD SET

SECOND FLOOR PLAN

SCALE: 1/4" = 1'-0"

GENERAL FLOOR PLAN NOTES
 UNLESS OTHERWISE NOTED:
 1. DIMENSIONS ARE TO OUTSIDE FACE OF STUD AT EXTERIOR WALLS, AND FACE OF FINISH AT INTERIOR WALLS.
 2. ALL INTERIOR WALLS ARE 24" STUDS, UNLESS OTHERWISE NOTED OR DIMENSIONED. ALL EXTERIOR WALLS @ MAIN FLOOR ARE 24" STUDS.
 3. WINDOW LOCATIONS ARE DIMENSIONED TO CENTERLINE OF OPENING. SEE WINDOW SCHEDULE FOR SIZES.
 4. IF NOT DIMENSIONED, DOORS SHALL BE 6" FROM ADJACENT WALL, OR CENTERED AS APPROPRIATE. SEE WINDOW SCHEDULE FOR SIZES.
 5. ALL ANGLES ARE 45° (UNLESS NOTED).

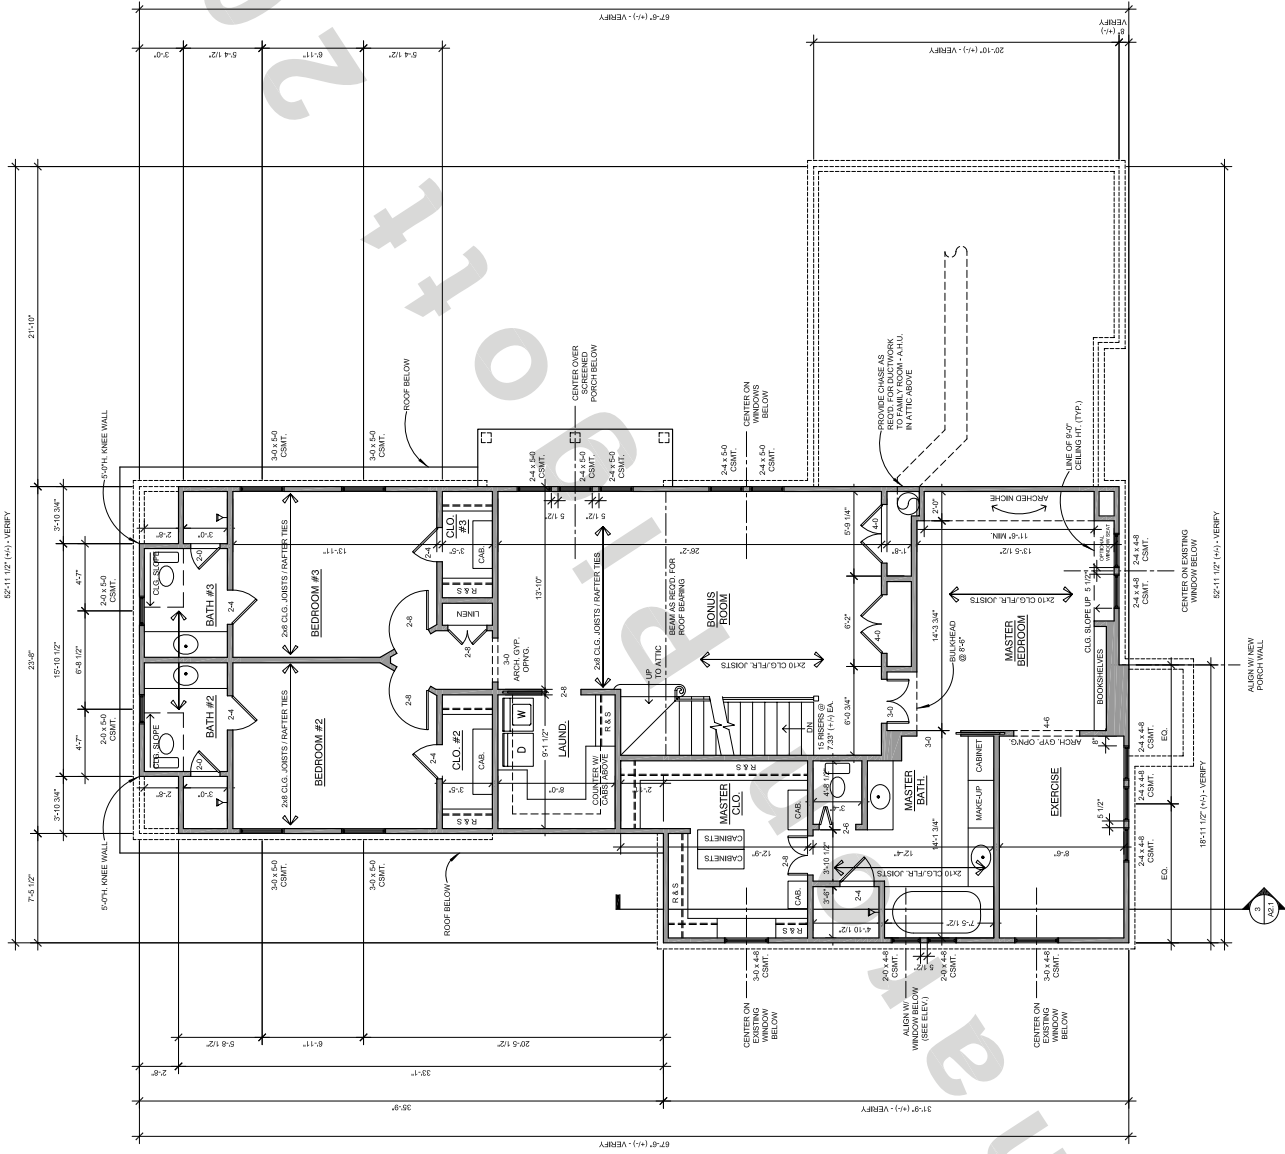

9000
 t
 2007